




Available Properties in Downtown Plymouth, MI

Office Space



Ann Arbor Trail and Main Street (Mayflower Center)

Call Jeff Gosselin: (734) 272-1262
Suite 408, 416 and 424

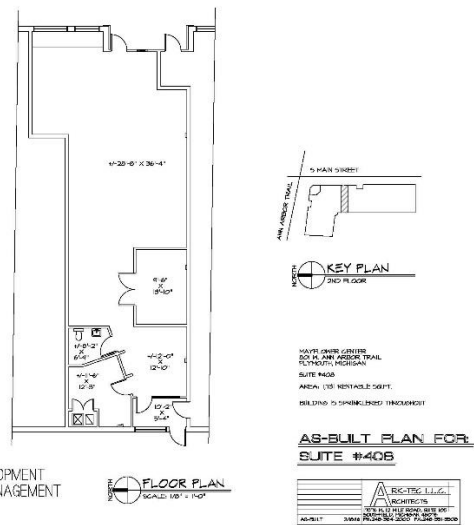


RSM DEVELOPMENT & MANAGEMENT
P.O. BOX 3073
BIRMINGHAM, MICHIGAN 48012
(248) 645-2600


FLOOR PLAN
SCALE: 1/8" = 1'-0"

AS-BUILT PLAN FOR SUITE #408


Suite 408

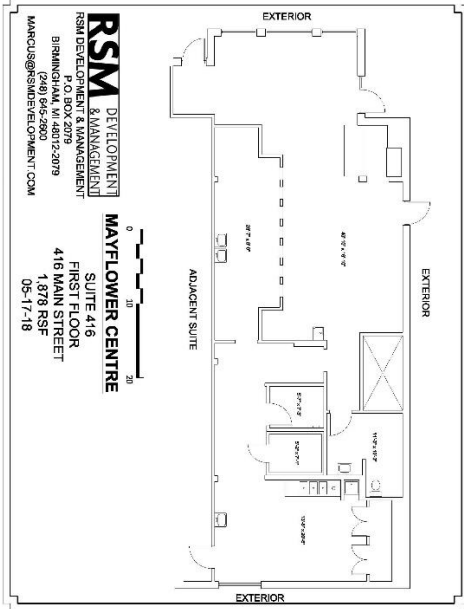

Suite 416

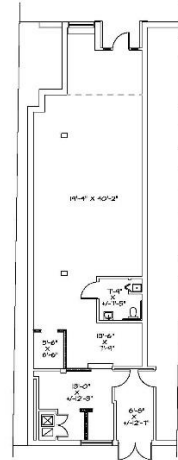

Suite 424

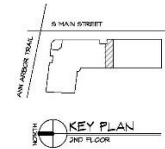

MAST JONES CENTRE
200 W. MAIN STREET TRAIL
PLYMOUTH, MICHIGAN
SUITE #424
AREA: 1,580 RENTABLE SQFT.
BUILDING IS SPRINKLERED THROUGHOUT

AS-BUILT PLAN FOR
SUITE #424

RSM DEVELOPMENT & MANAGEMENT
P.O. BOX 3075
BIRMINGHAM, MICHIGAN 48012
248 645-2620

FLOOR PLAN
SCALE: 1/8" = 1'-0"

AS-BUILT
SCALE: 1/8" = 1'-0"



Pastel Plymouth 447 Forest Ave. , Suite 1

Office Spaces- Share Workspaces & Private

Private Offices Available

Call for more information: (734) 404-8232

Email: hello@pastelplymouth.com

<http://www.pastelplymouth.com>



206 S. Union

1400 square feet office space
Contact Bake Real Estate at 734-272-8375



292 South Main

Approximately 925 SF
This is an upstairs office space
Asking \$2000/mo gross rent
Contact John at 734.216.1932



Downtown
PLYMOUTH



Not Just a Walk in the Park



485 S. Main Street

Located in the Meeting House building

Approximately 827 SF

First floor office space offers a large open, communal area, two separate offices, additional storage and breakout rooms as well as a private restroom

\$1,150 Gross Lease

3 Year Minimum

Contact Lindsey (734) 716-0456

Downtown
PLYMOUTH



Not Just a Walk in the Park



Retail Space



983 W. Ann Arbor Tr. Suite 17

800 sq. ft. first floor

700 sq. ft. 2nd floor

Asking 20.00 per sq. ft. gross, plus utilities

Available November 1

Contact Vince at 734-453-4555